



HUKKELBERG

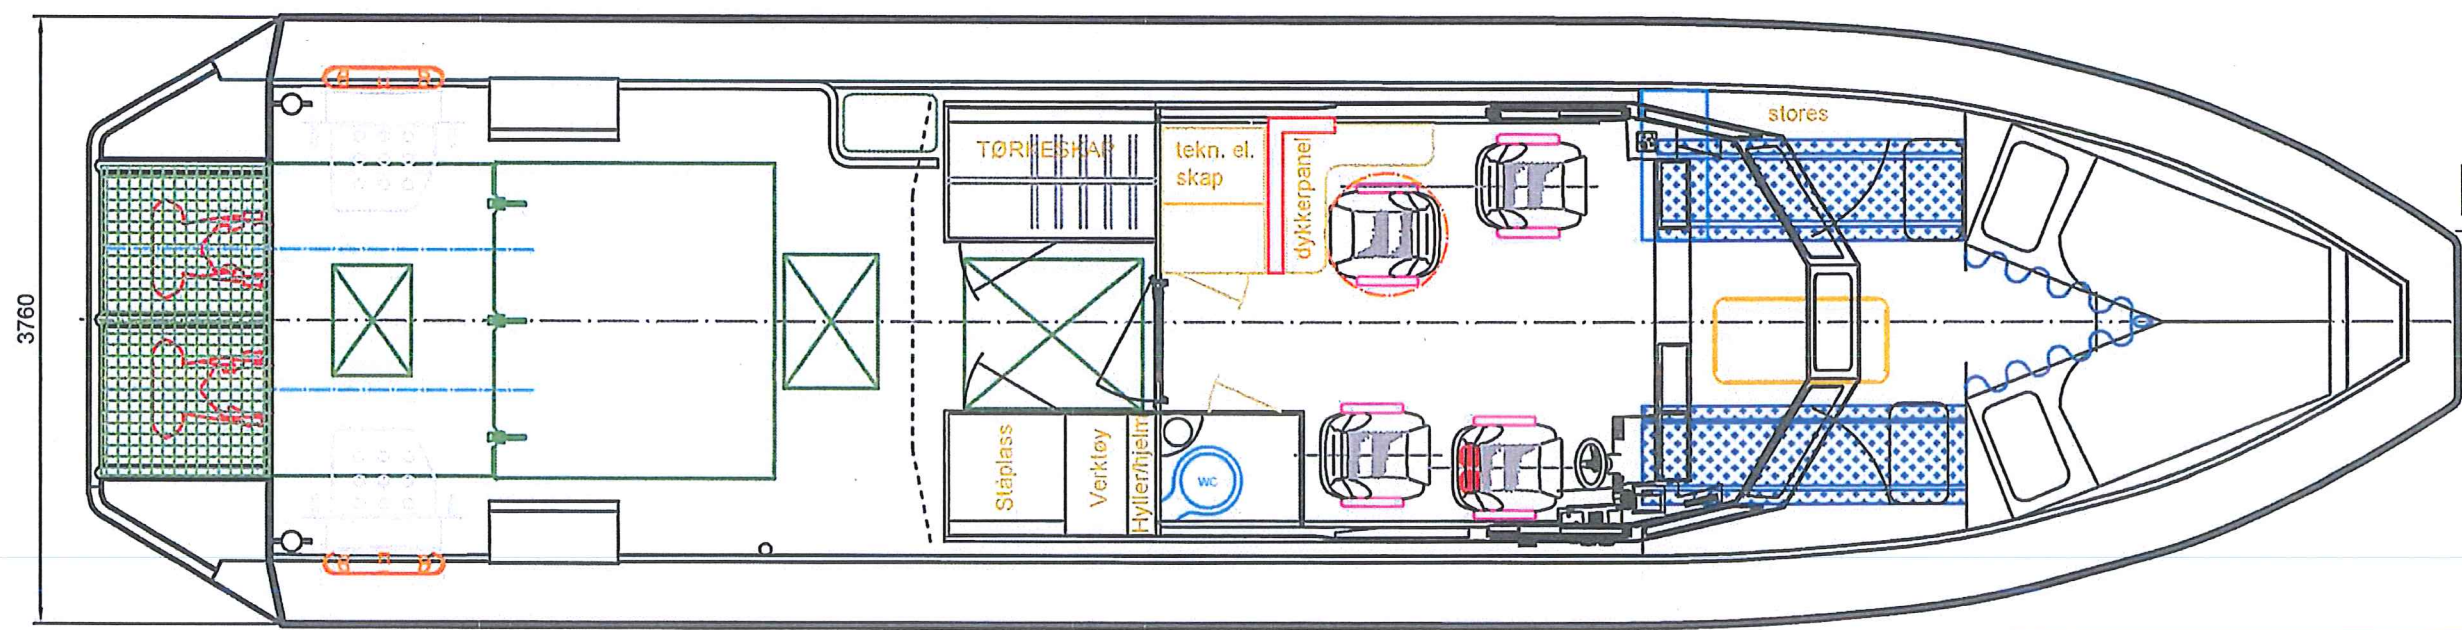

BOATS™

OF NORWAY

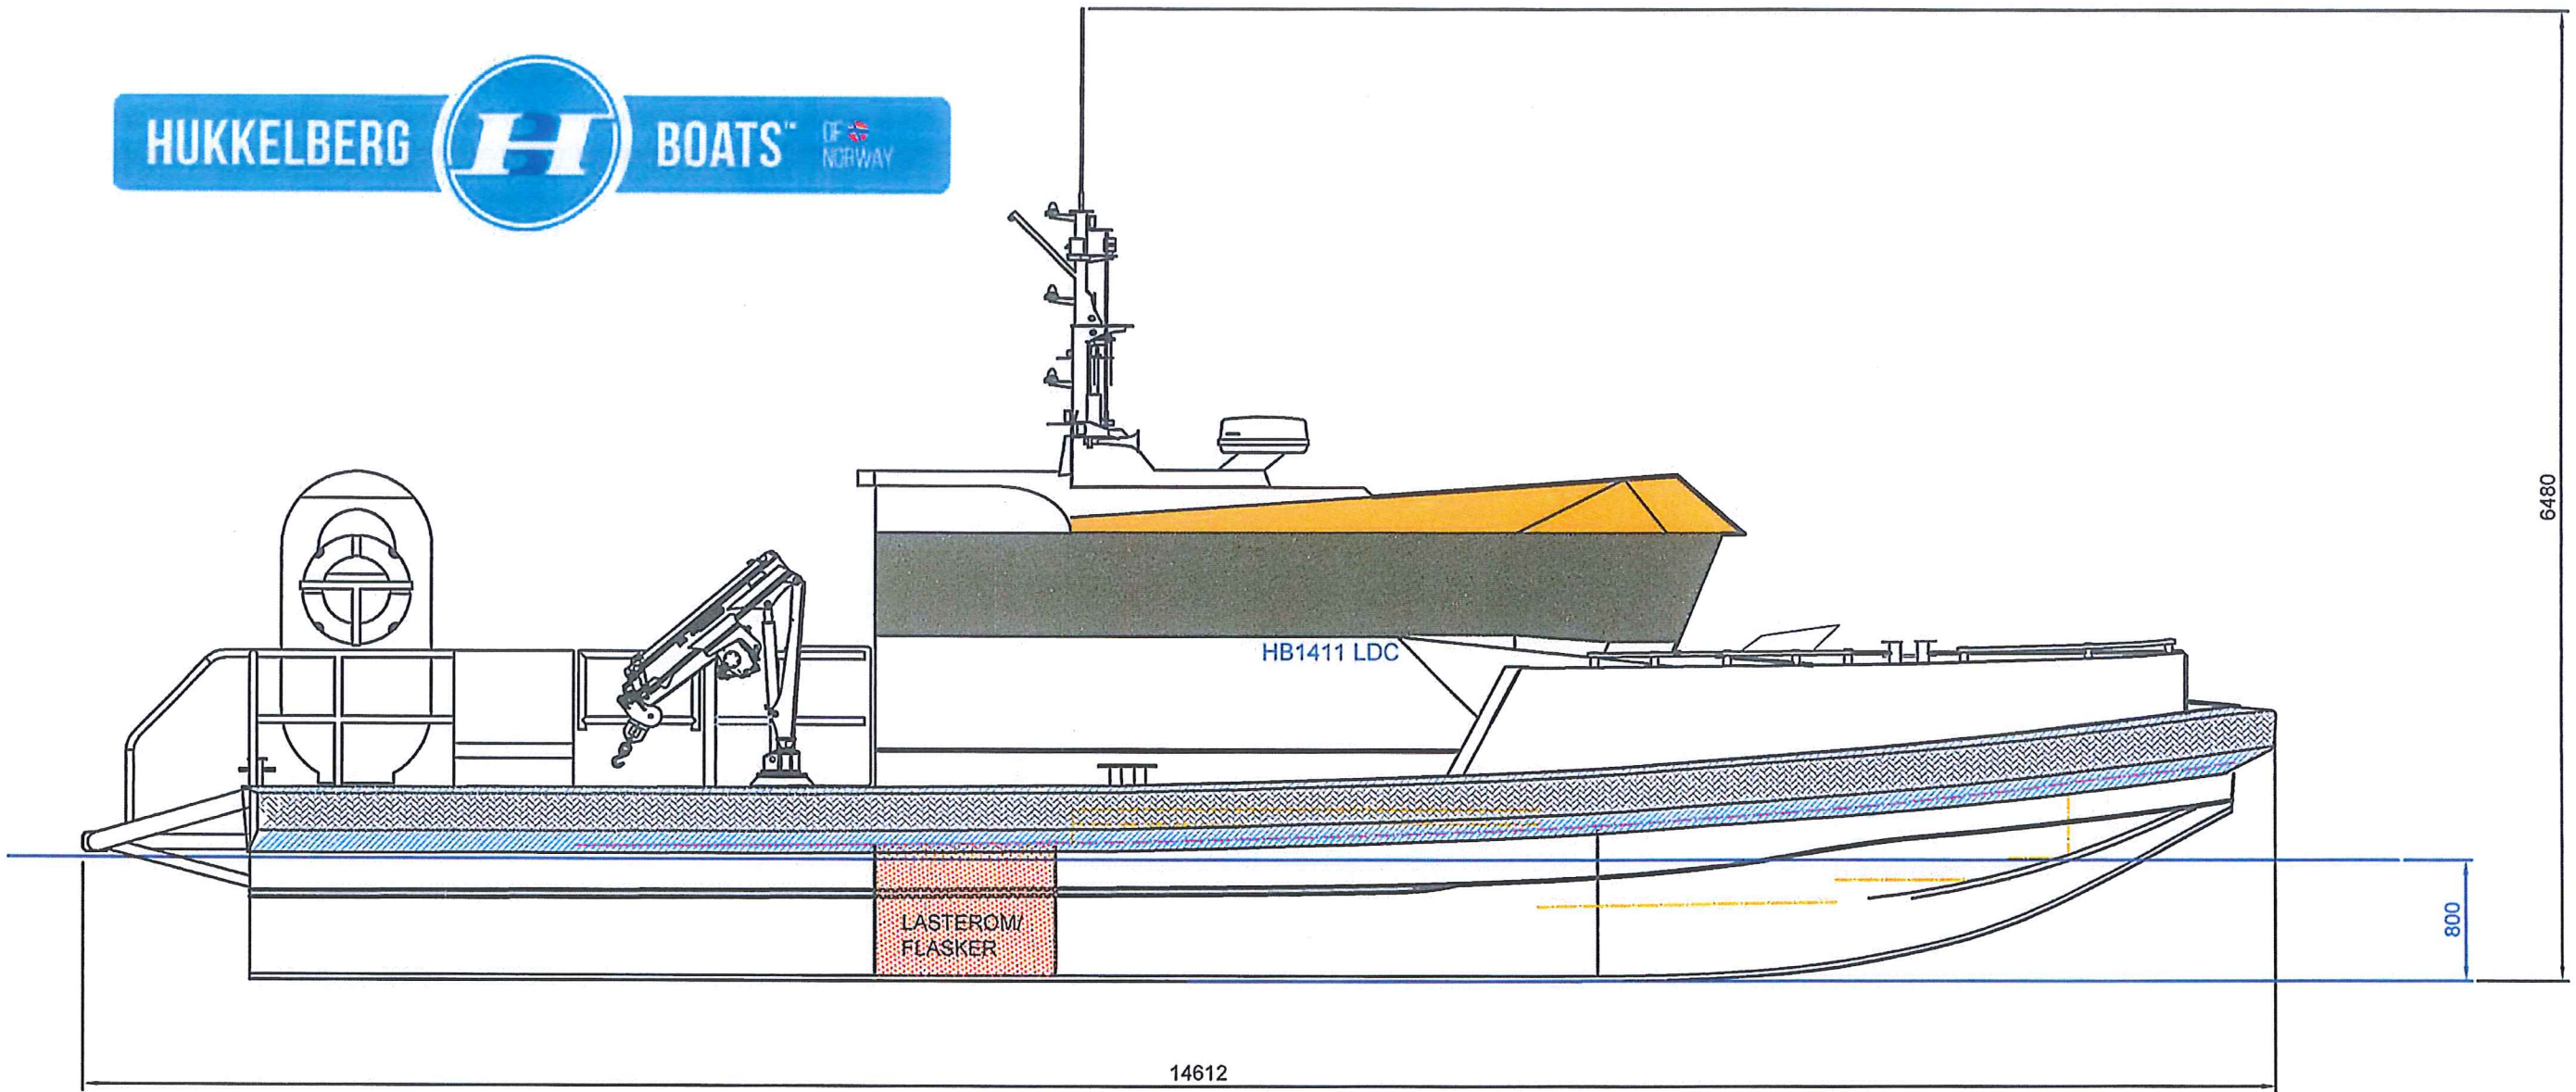

HB-1411LDC

MAIN DIMENSIONS

LENGTH OVERALL: 14.615 m
 LENGTH ALUM. HULL: 13.180 m
 BREADTH HULL: 2.950 m
 BREADTH EXTREME: 3.760 m

Brdr. Hukkelberg AS 6480 Aukra Norway Tel: +47 711 71800 www.hukkelberg.no	PROJECT: JOB No:	Revisions:	18.06.2019 as built (measured P.B.) 24.09.2018 drawn	K 0
		SCALE: - (A3)	DRAWN: P.R.	DATE: 24.09.2018
GENERAL ARRANGEMENT - HB1411 LDC		DRG No: 240918 - 001GA K		